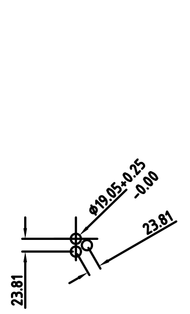

PITCH DET.
SC. 1:8

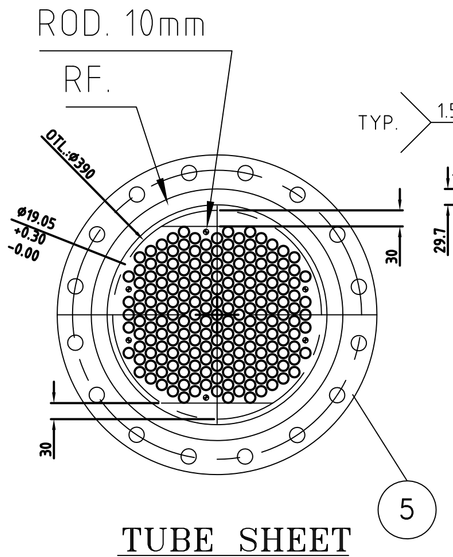

TUBE SHEET
SC. 1:8

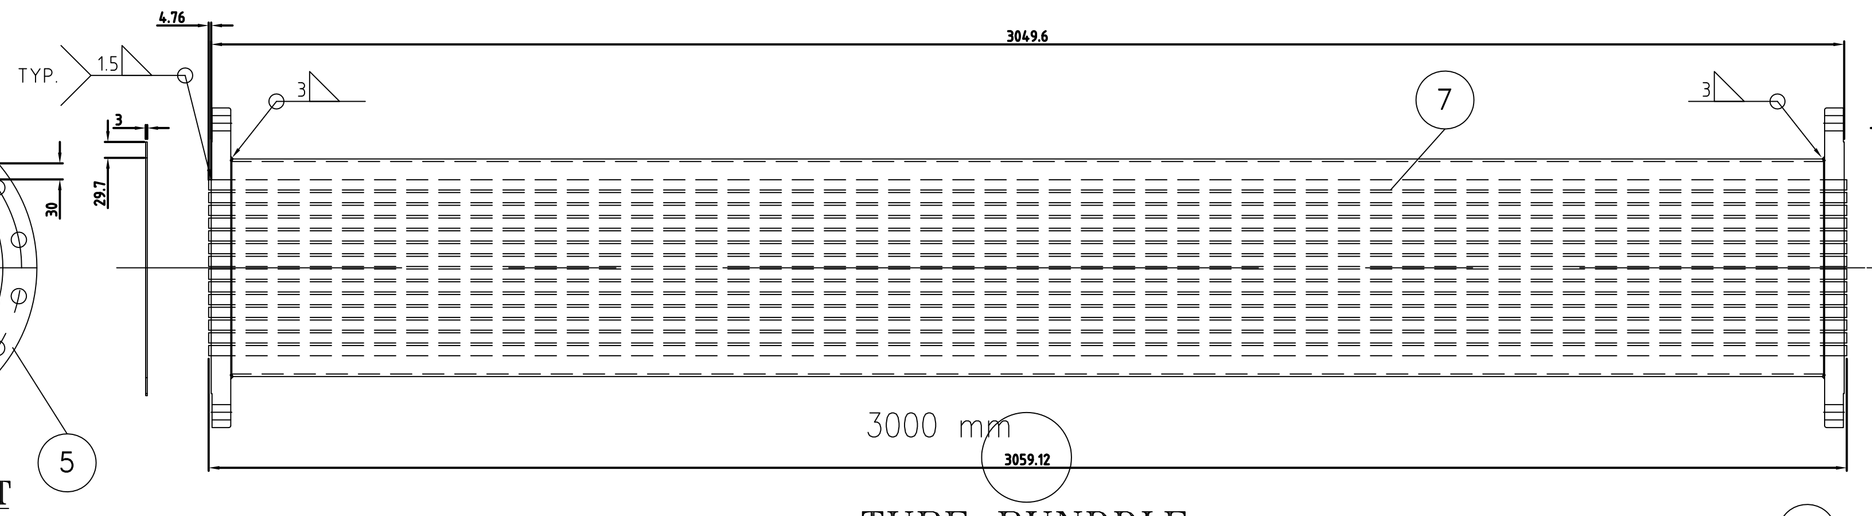

TUBE BUNDDLE
SC. 1:8

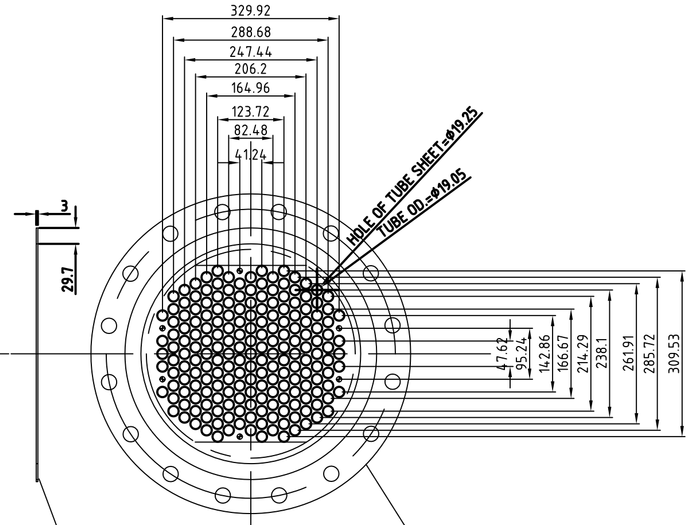

TUBE SHEET
SC. 1:8

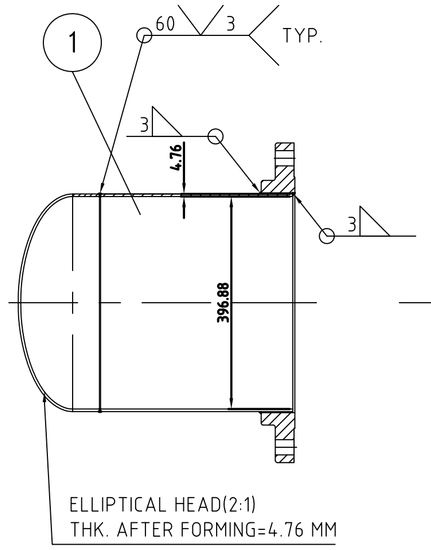

BODY FLANGE–LEFT
SC. 1:8

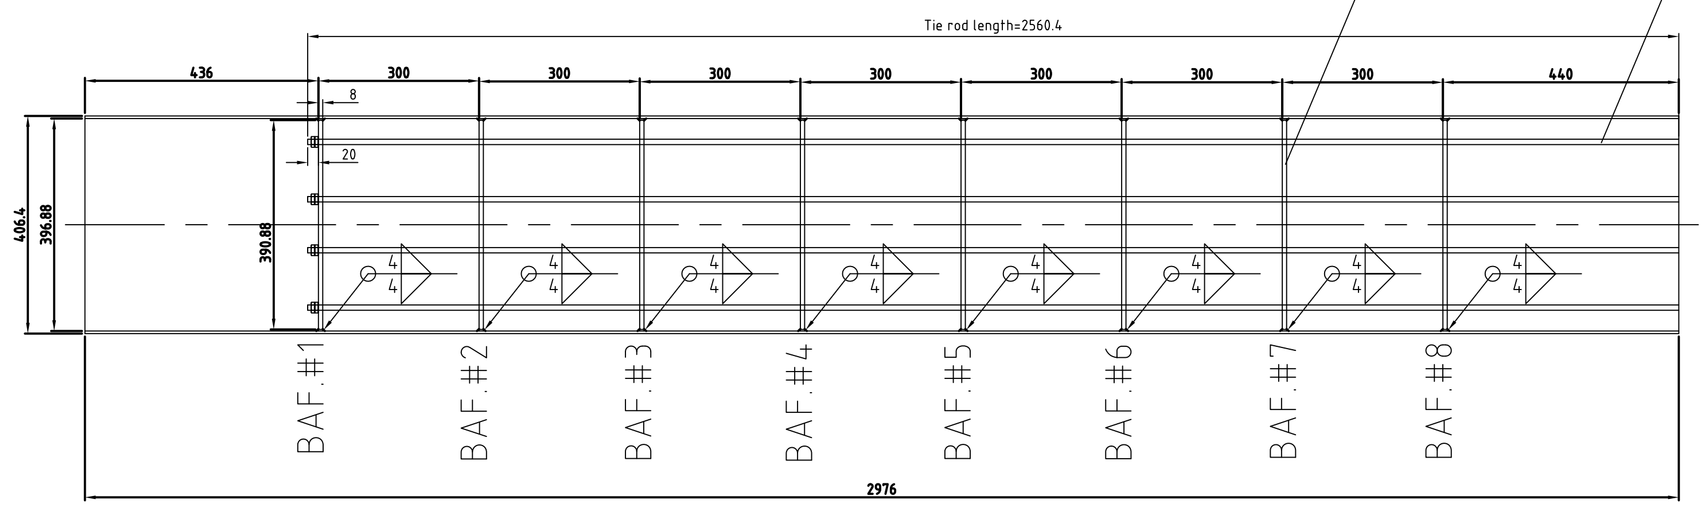

BAFFLE ARRANGEMENT
SC. 1:8

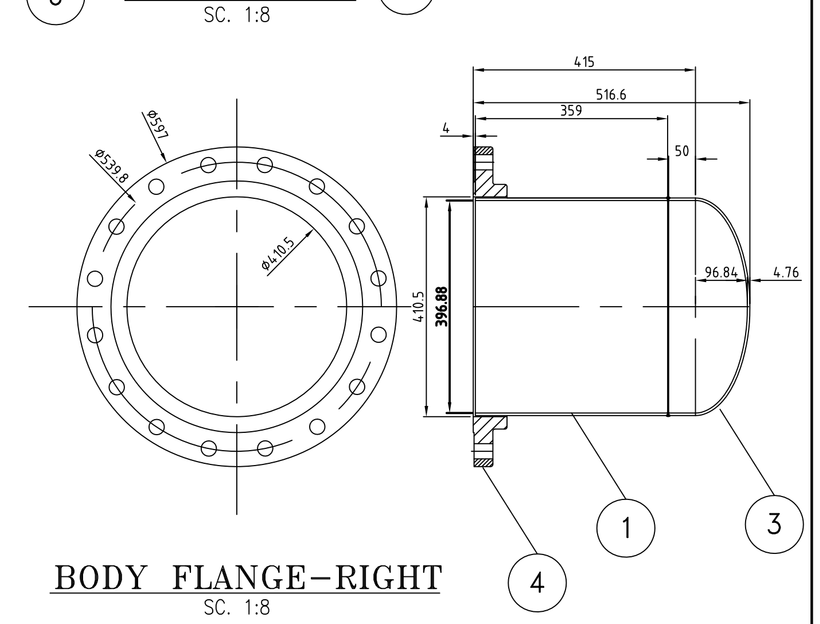

BODY FLANGE–RIGHT
SC. 1:8

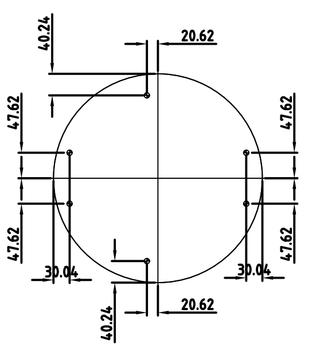

TIE ROD ORIENTATION
SC. 1:8

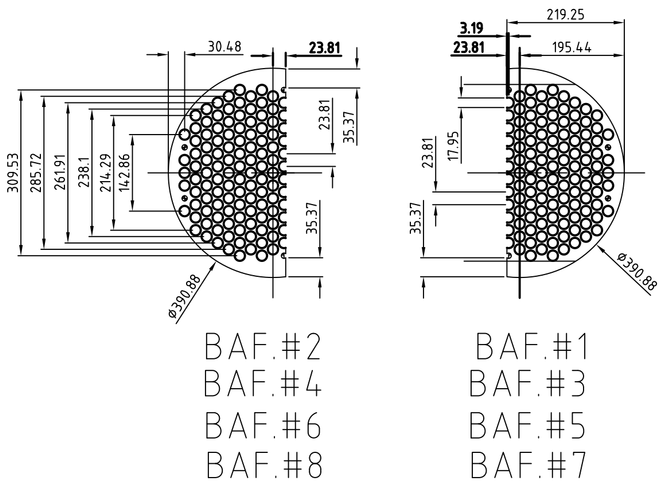

ARRANGEMENT BAFFLES
SC. 1:8

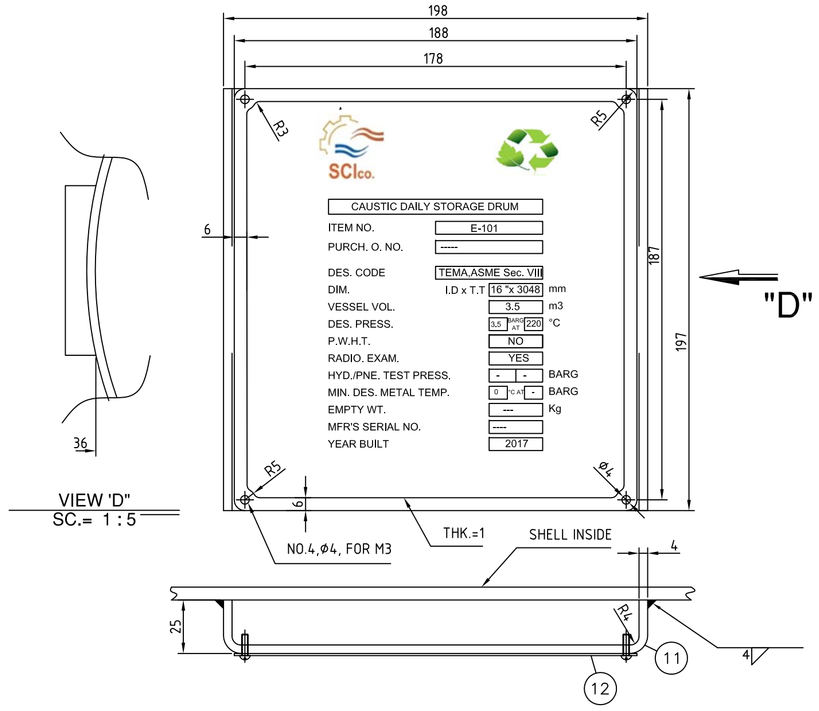

NAME PLATE
SC.= 1 : 2

PART LIST

POS.	PART NAME	DESCRIPTION	QTY.	MATERIAL	UNIT WEIGHT (Kg)	TOTAL WEIGHT (Kg)	REMARKS
1	F./R. CHANNEL	P.16", THK.=4.76mm, L=359mm	2	SA312 TP304L	17.1	34.2	
2	SHELL	P.16", THK.=4.76mm, L=2976mm	1	SA312 TP304L	141.9	141.9	
3	F./R. HEAD	CAP 16", THK.4.76mm	2	SA312 TP304L	20.0	40.0	
4	F./R. BODY FLG.	FLG.16", S.O., 150#	2	SA182 TP304L	13.7	27.4	
5	F./R. TUBE SHEET CHANNEL	BLD.16", S.O., 150#	2	SA182 TP304L	81.7	163.4	
6	GASKET	FOR 16", S.O., 150#	2	METAL,MONEL TP304L	1.0	2.0	
7	TUBE	TUBE ø19.05, THK.=1.65mm, L=3060	195	SA312 TP304L	2.2	425.1	
8	BAFFLE	PL. 390.88x219.25X8THK.	8	SA240 TP304L	5.4	43.4	
9	TIE ROD	ROD ø10mm, L=2561	6	S.S 304L	1.6	9.6	
10	FLANGE N1, N9	FLG 6", S.O., 150#	2	SA182 TP304L	0.0	0.0	
11	PIPE N1, N9	P. 6", STD, L=217mm	2	SA312 TP304L	0.0	0.0	
12	PAD N1, N9	PL.238x5mm	2	SA240 TP304L	0.0	0.0	
13	Nozzle N11, N12	Half coupling 1" 3000#	2	SA182 TP304L	0.0	0.0	
14	deleted	deleted					
15	COUPLING N2,N3,N5,N7,N10	COUPLING ½" 3000#	5	S.S. TP304L	0.0	0.0	
16	FLANGE N4	FLG 10", S.O., 150#	1	SA182 TP304L	0.0	0.0	
17	PIPE N4	P. 10", STD, L=250mm	1	SA312 TP304L	0.0	0.0	
18	PAD N4	PL.407x5mm	1	SA240 TP304L	0.0	0.0	
19	FLANGE N6, N8	FLG 2", S.O., 150#	2	SA182 TP304L	0.0	0.0	
20	PIPE N6, N8	P. 2", STD, L=205mm	2	SA312 TP304L	0.0	0.0	
21	WEAR PLATE	PL.480x250x5	2	SA240 TP304L	0.0	0.0	
22	WEB PLATE	PL.635x361x8	2	SA240 TP304L	0.0	0.0	
23	RIB PLATE–SIDES	PL.635x96x8	8	SA240 TP304L	0.0	0.0	
23	RIB PLATE–MID	PL.532x96x8	4	SA240 TP304L	0.0	0.0	
24	STUD BOLT FOR BODY FLANGE	M27, L=145mm	32	SA193 B8	0.0	0.0	
25	NUT FOR BODY FLANGE	M27	64	SA194 B8	0.0	0.0	
26	LIFTING LUG	PL. 200x145x5	2	SA240 TP304L	0.0	0.0	
27	LIFTING LUG PAD	PL. 220x100x5	2	SA240 TP304L	0.0	0.0	
				TOTAL WEIGHT=(Kg)		216	

TOTAL WEIGHT FOR 3 HEAT EX. = --- Kg

AS–BUILT

NOTES

1. ALL DIMENSION ARE IN mm. UNLESS OTHERWISE SPECIFIED.

Employer: Sarcheshmeh Copper Investment Co.

Consultant: ParsBonyan Consulting Engineers

Contractor: Kimia Neshan Kerman Sabz

DWG Title: General Arrangement and detail drawing FOR E–101,102,103

Project Title: Sodium Sulfide

Designed By:		DWG Type:	Size:
Prepared By:			Scale:
Checked By:		DWG No.:	Rev.:
Approved By:		SCI01–ME–DWG–E123–072	Sheet: